


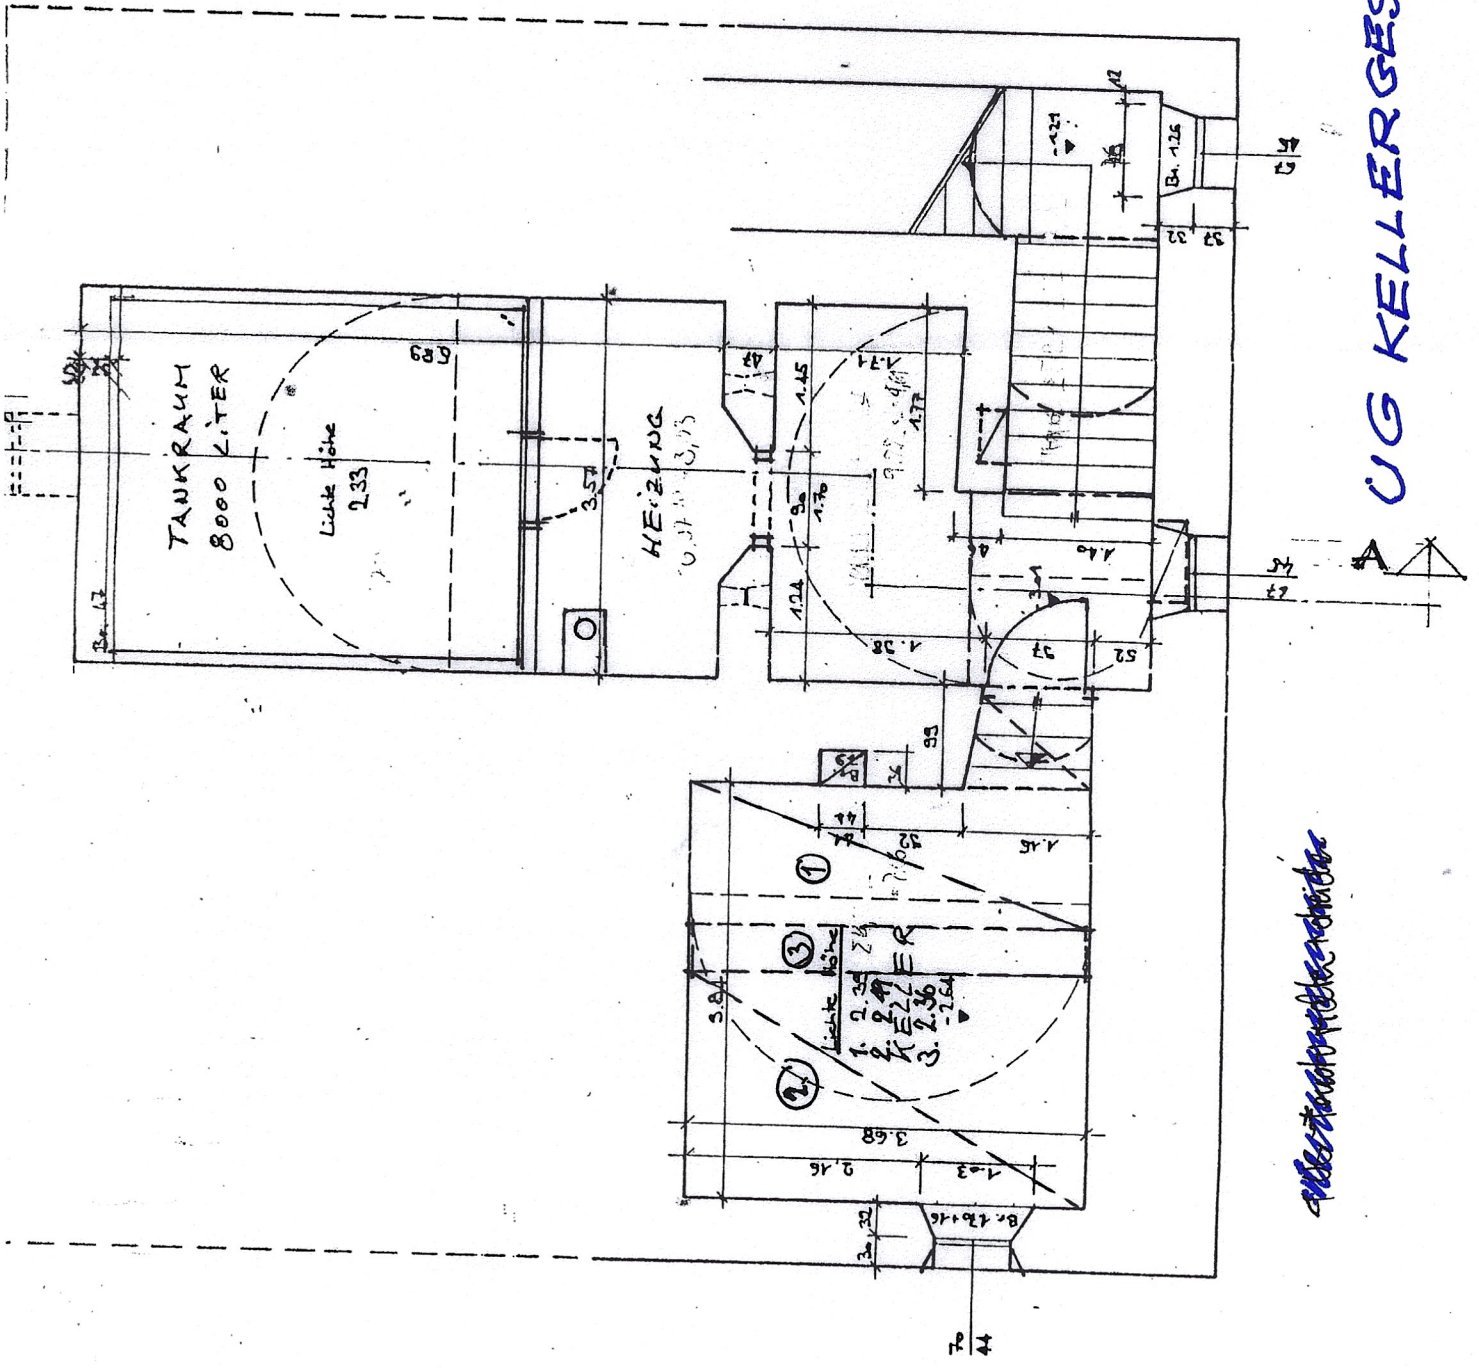

UG KELLERGESCHOSS

Handwritten note in blue ink: ~~Handwritten text, possibly 'Handwritten note' or similar.~~

BESTANDSPLAN
UG M:1:50

Handwritten note in blue ink: ~~Handwritten text, possibly 'Handwritten note' or similar.~~

KORREKTUR UND VERÄNDERUNGEN

ZUR KIRCHE 5
86643 RENNERTSHOFEN-HÜTTING
TEL: 08427 - 866580 FAX: - 986585