


WE 1 EG

Wohnen	18,95 m ²
Schlafen 1	15,45 m ²
Schlafen 2	12,89 m ²
Diele	11,27 m ²
Bad	2,87 m ²
Küche	8,44 m ²
Balkon (4,10 x 0,5)	2,05 m ²
WE 1 EG GESAMT	71,92 m²

WE 2 EG

Wohnen	18,53 m ²
Schlafen 1	15,94 m ²
Schlafen 2	12,58 m ²
Diele	11,12 m ²
Bad	2,86 m ²
Küche	8,78 m ²
Balkon (4,10 x 0,5)	2,05 m ²
WE 2 EG GESAMT	71,86 m²

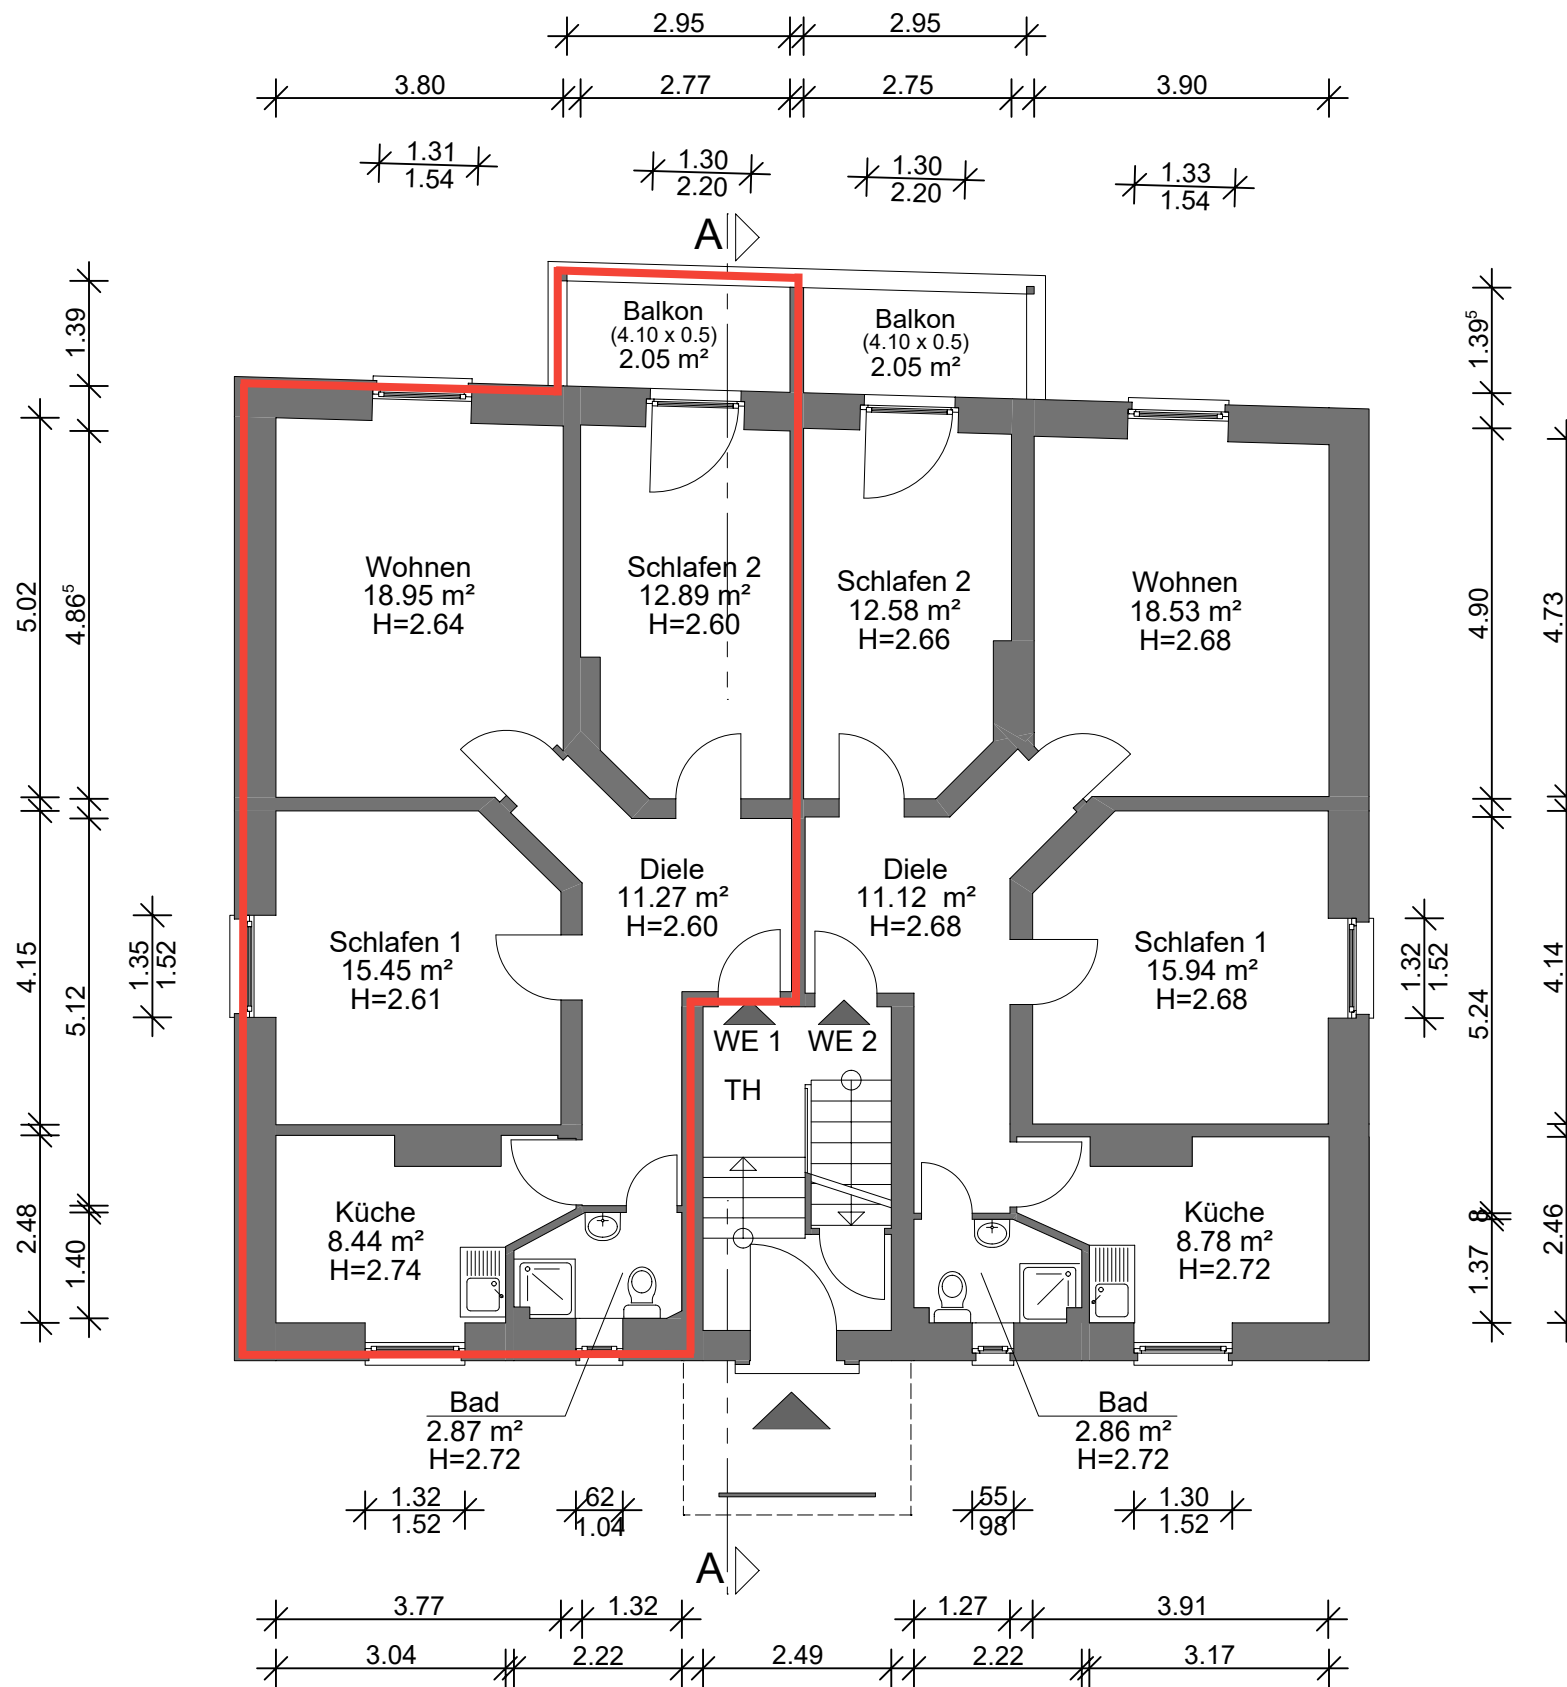

PROJEKT

Mercatorstraße 27A
60316 Frankfurt am Main



BESTANDSPLAN

PLAN	NR
EG	02

MASSTAB
1:100
DATUM
06.09.2021

VESTA-Immobilien
Luginsland 1
60313 Frankfurt am Main