


1.OG WE 2


Wohnen	28,89	m²
Essen	16,26	m²
Eltern	21,51	m²
Kind 1	19,01	m²
Kind 2	20,88	m²
Küche	2,81	m²
Diele	18,77	m²
WC	1,62	m²
Bad	3,75	m²
Abst. 1	0,32	m²
Abst. 2	2,26	m²
Loggia	(5,326 x 0,5 m²)	2,31 m²
Balkon	(2,08 x 0,5 m²)	0,95 m²

1.OG WE 2 Gesamt 139,32 m²

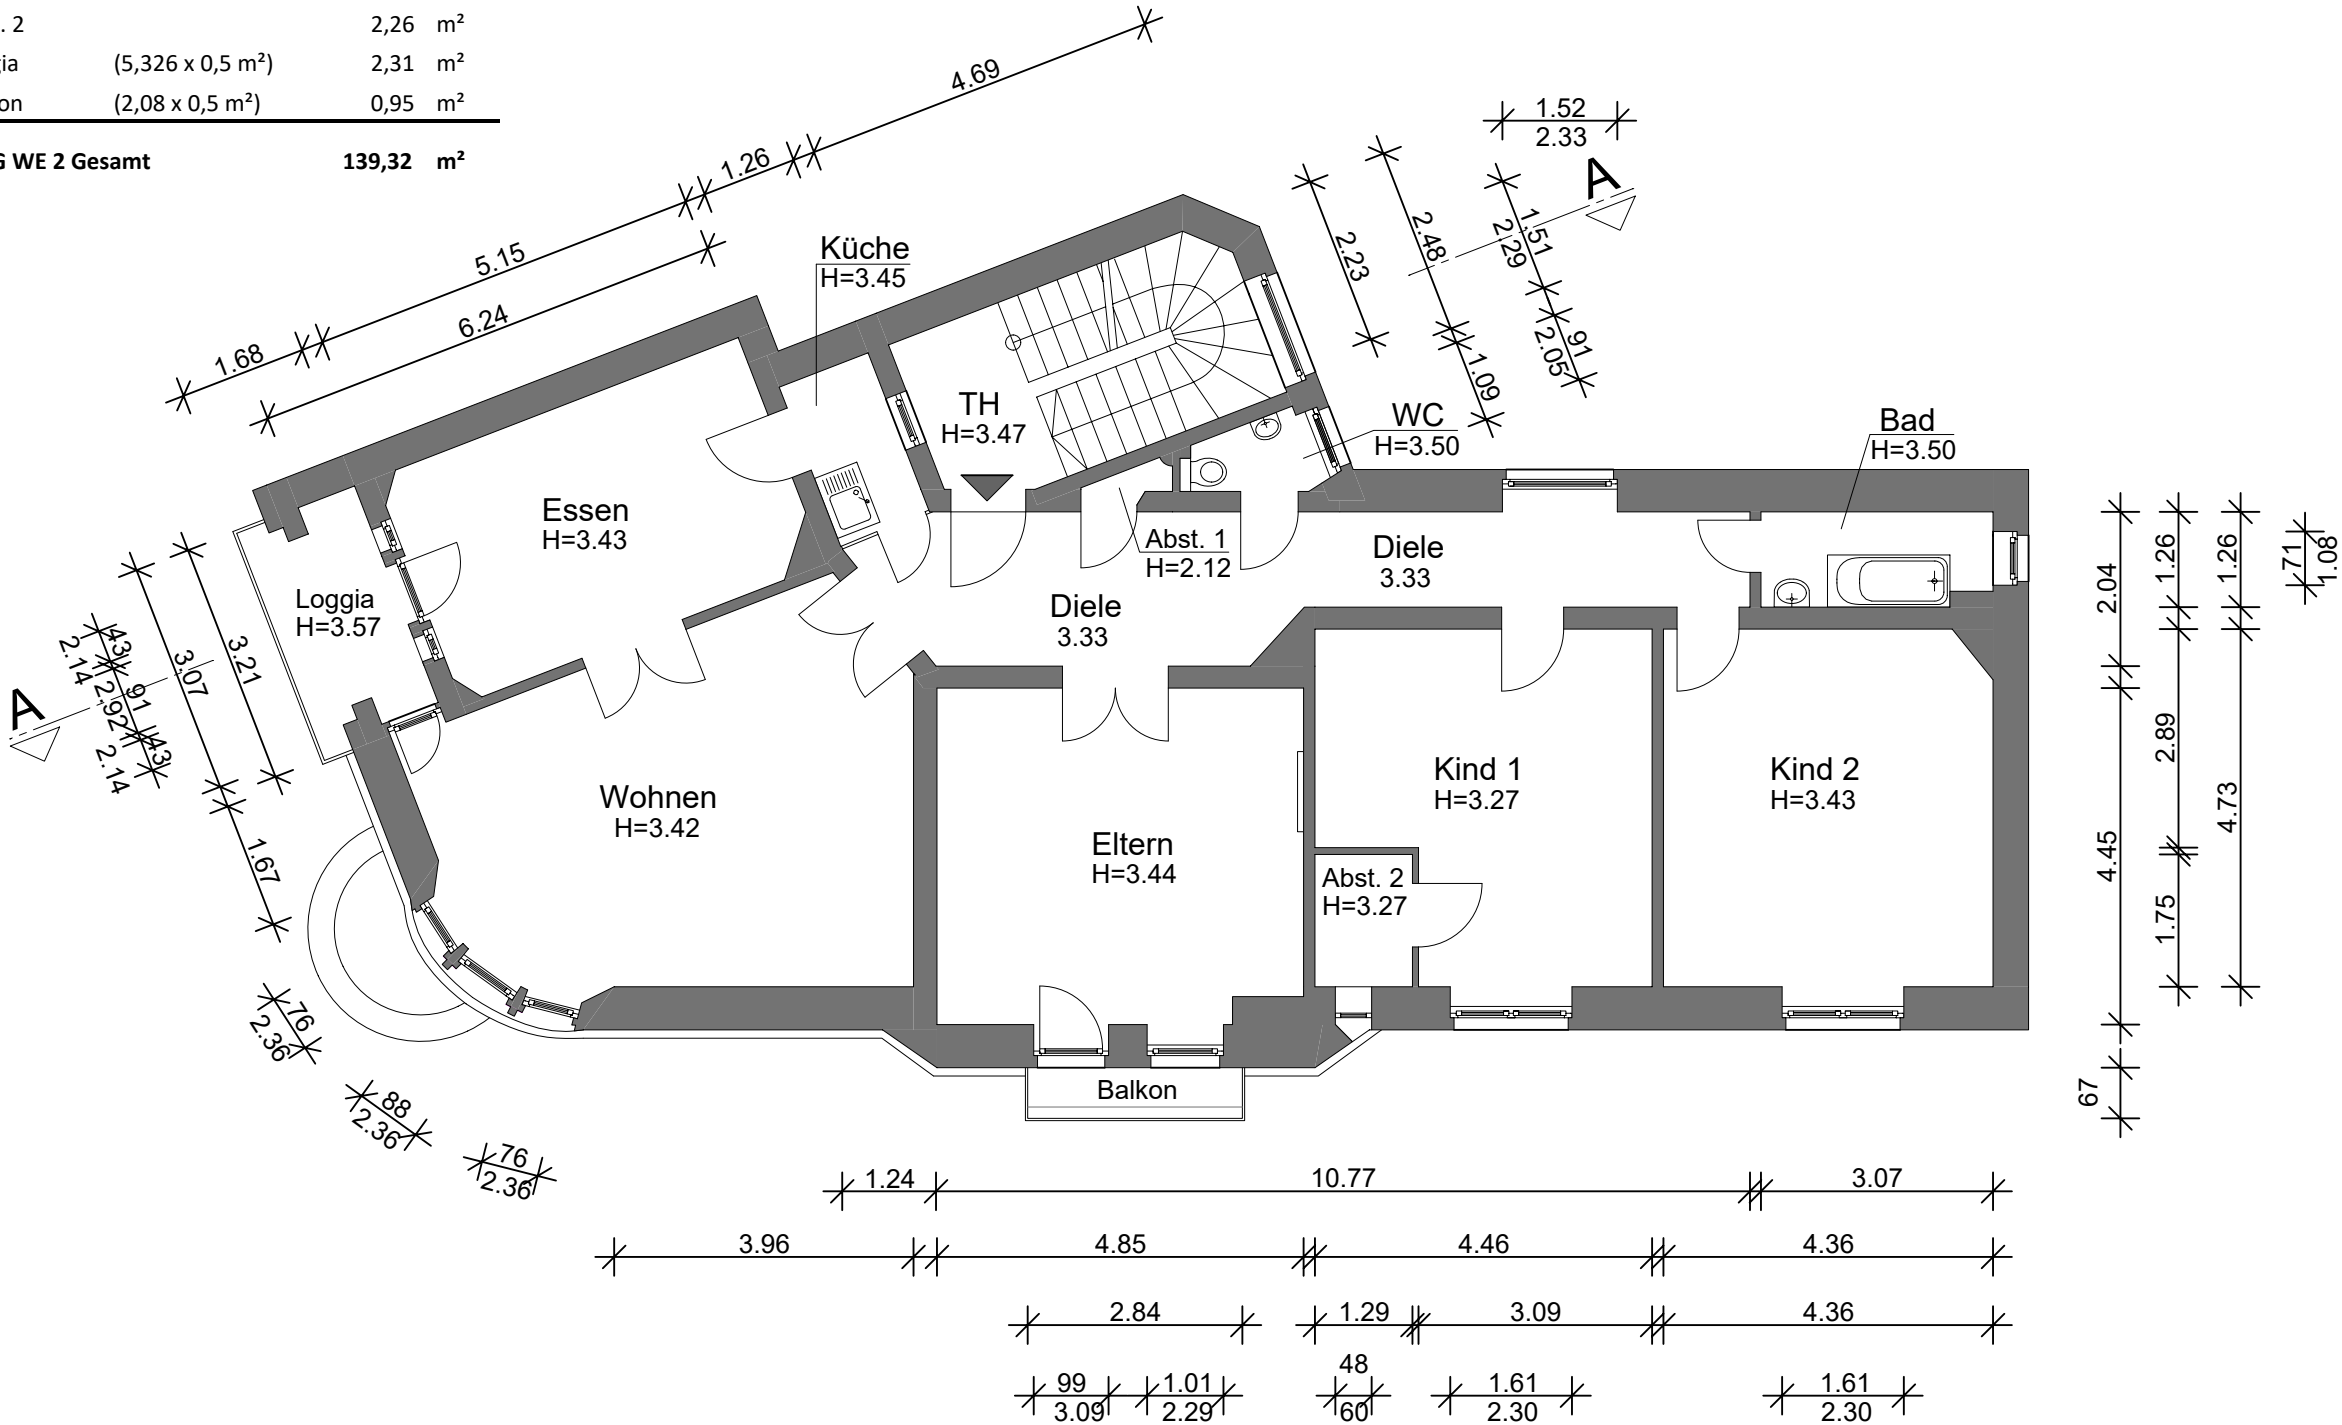

PROJEKT

Günthersburgallee 50
60316 Frankfurt am Main

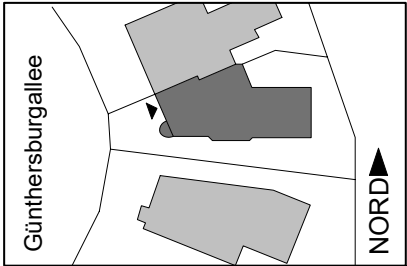

VESTA-Immobilien
Luginsland 1
60313 Frankfurt am Main

BESTANDSPLAN

PLAN NR
1.OG 03



MAßSTAB
1:100
DATUM
02.02.2021