


Wohnfläche = $37,93 / -50\%$ Dachstuhl
= $18,97 \text{ qm}$

DACHGESCHOSS

BESTANDSPLAN M 1:100

$$3,3 \times 4,2 = 13,86$$

$$\text{Flur } 3,3 \times 1,7 = 5,61$$

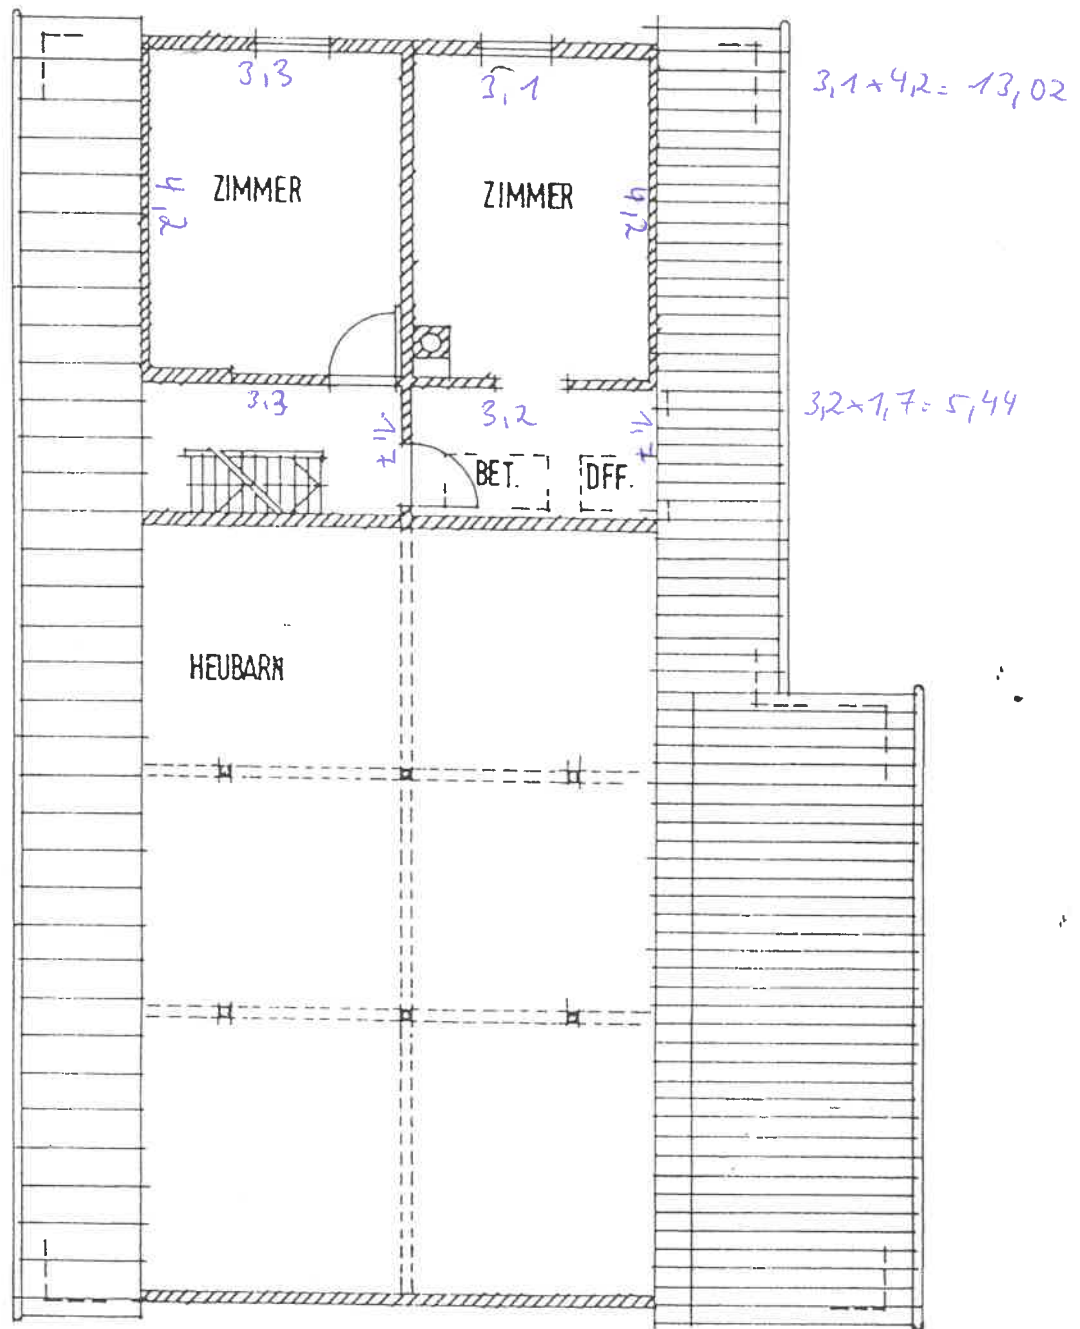

$$3,2 \times 1,7 = 5,44$$