


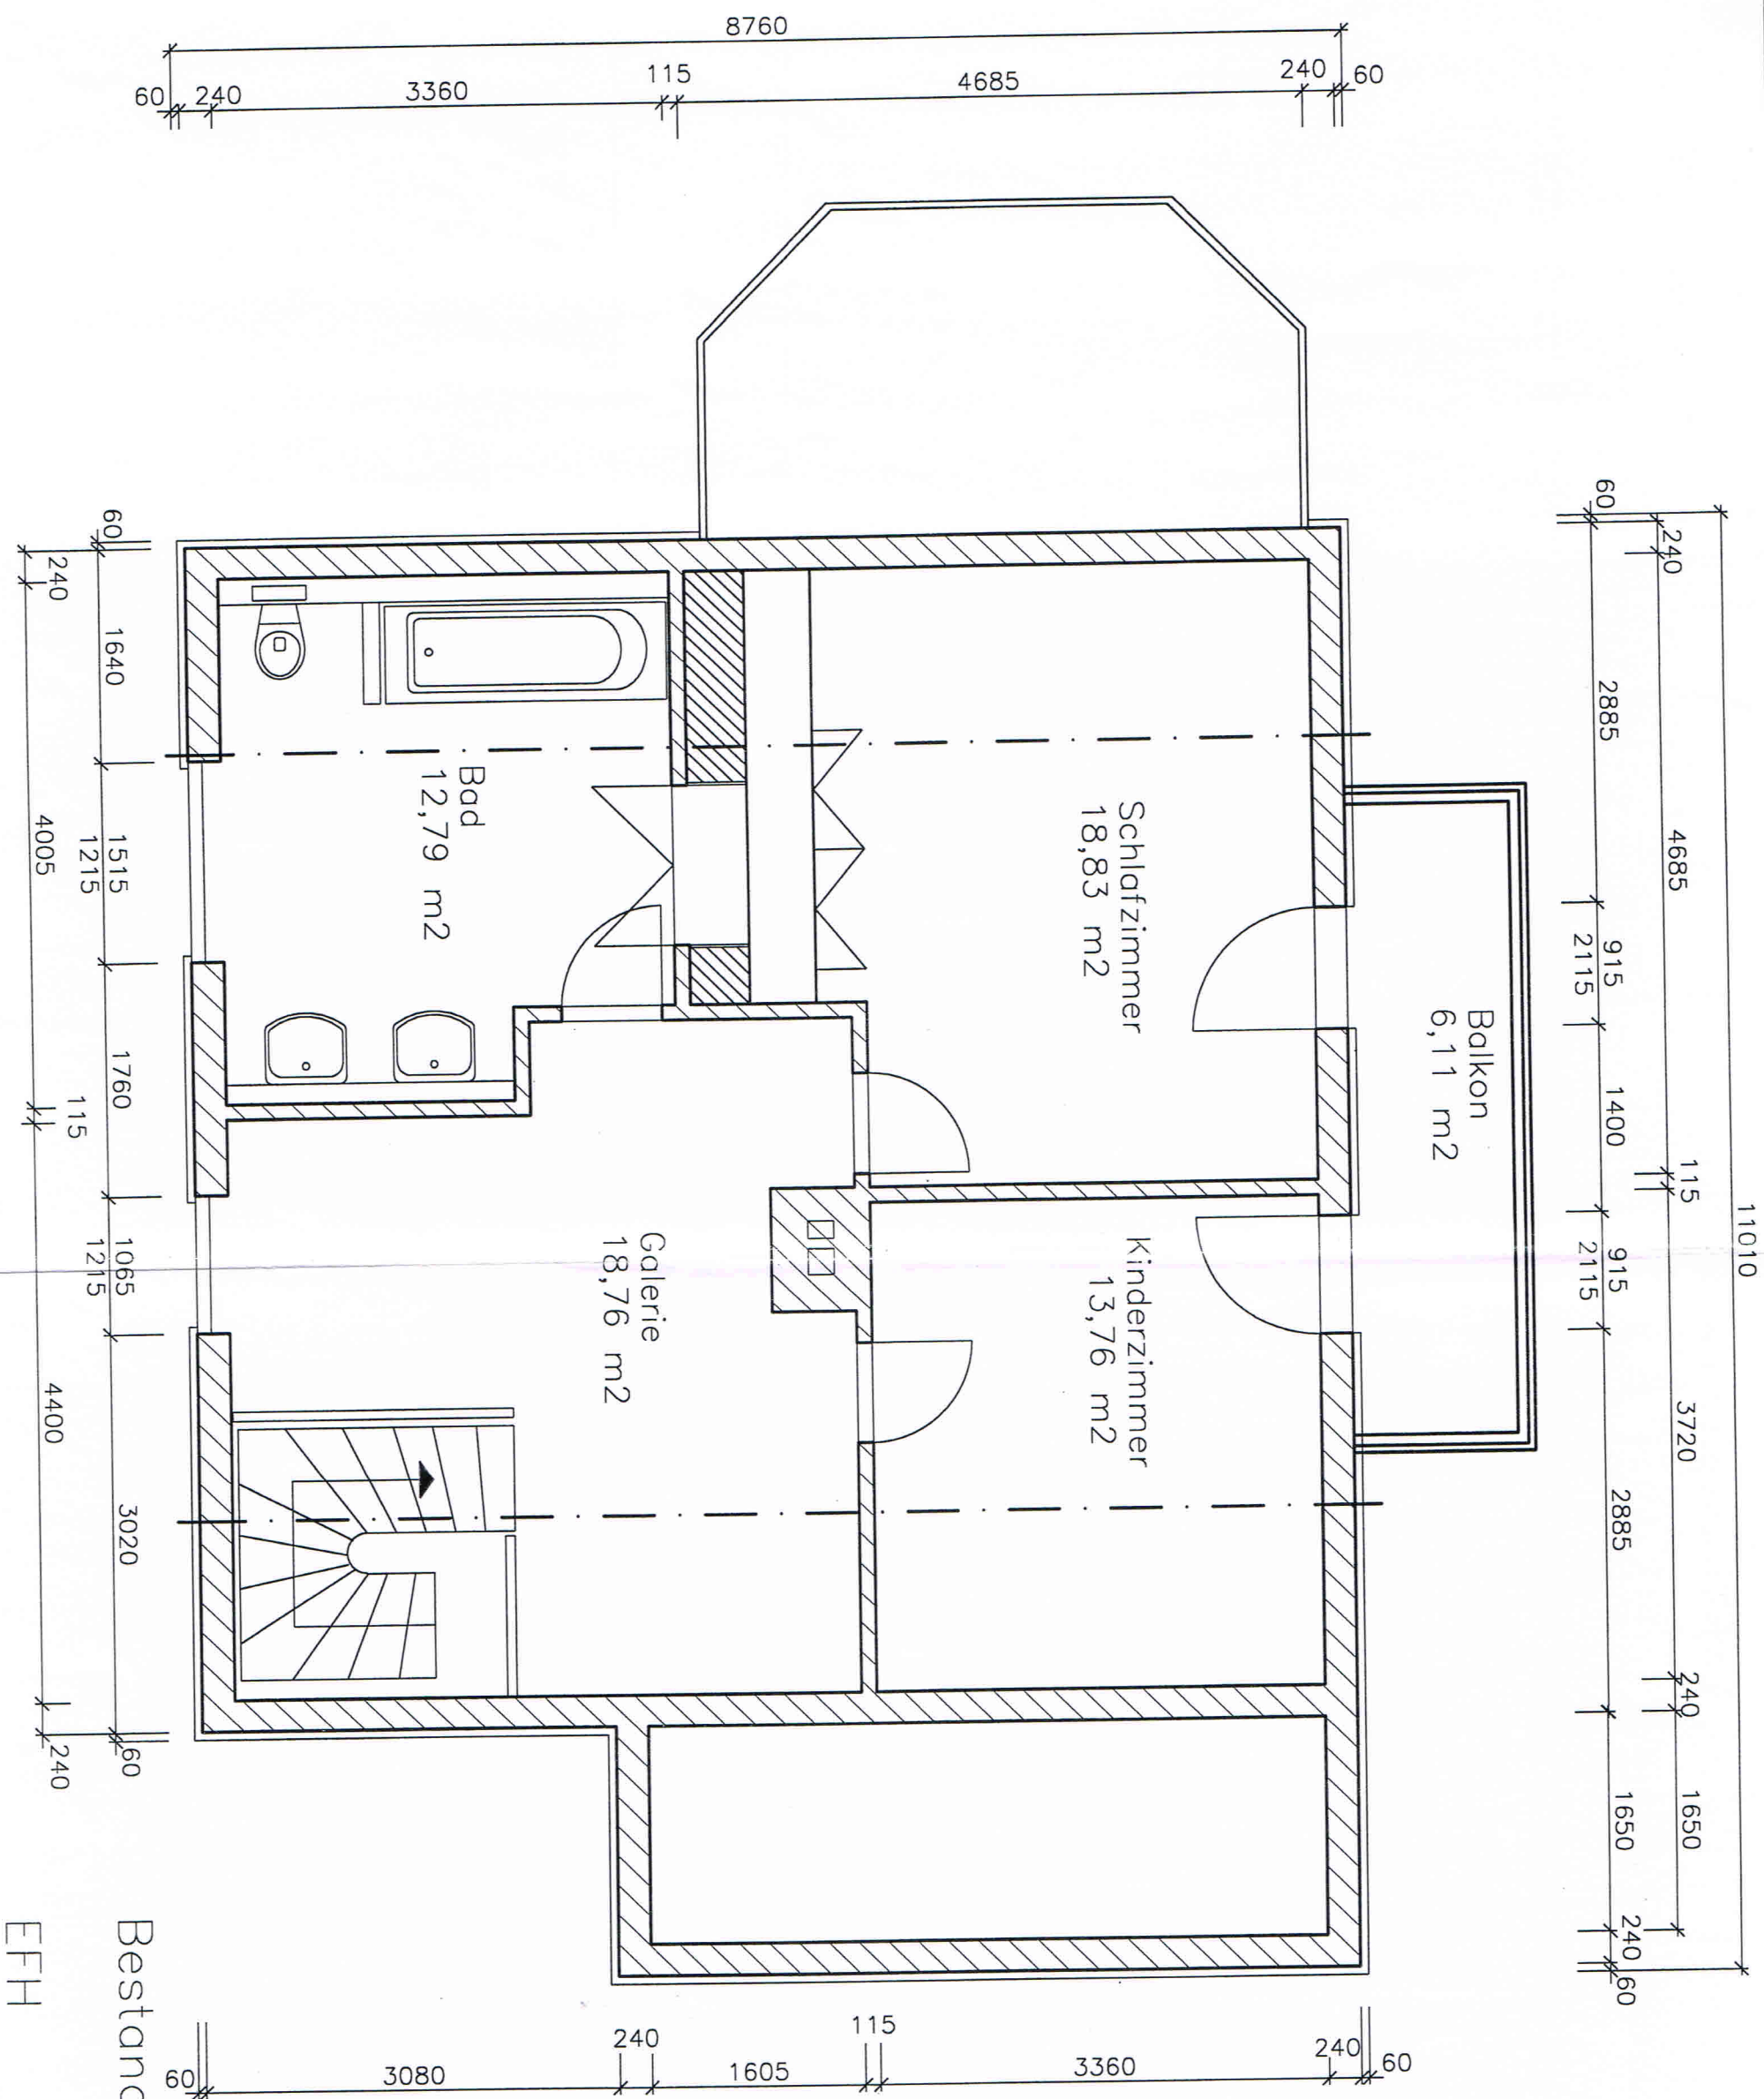

Bestandsplan DG

EFH