


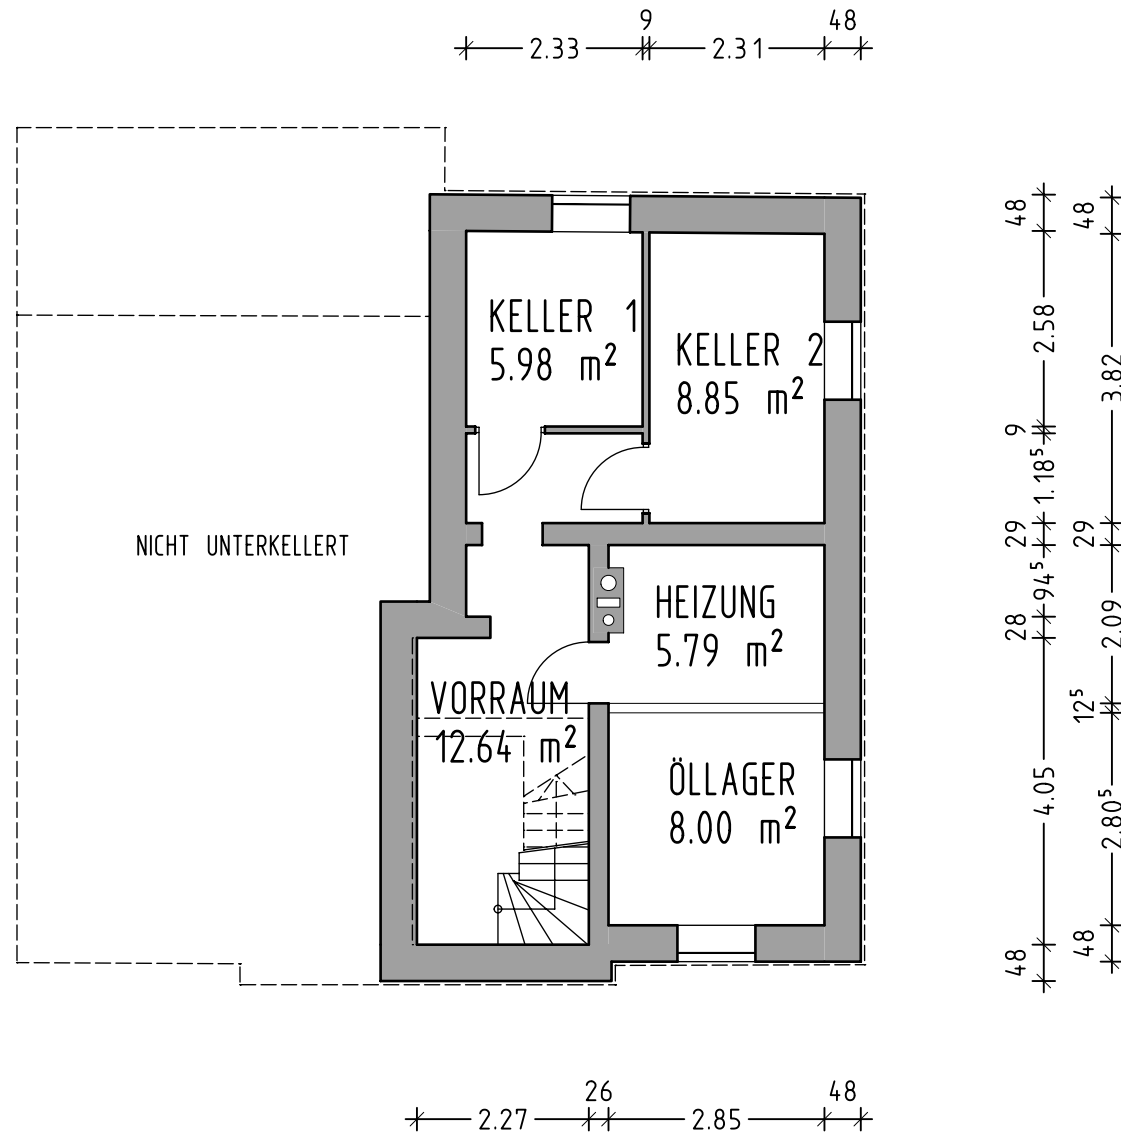

KELLERGECHOSS

Bestandsplan M = 1:10
Dr. -Thenn-Str. 13, Beilngries