


OBERGESCHOSS
BESTANDSPLAN M 1:100

$$4,3 \times 4,2 = 18,06$$

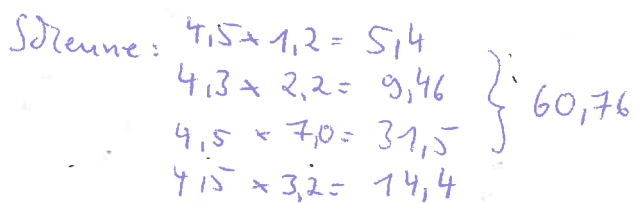

Terrasse: $8,3 \times 5,5 = 45,65$