
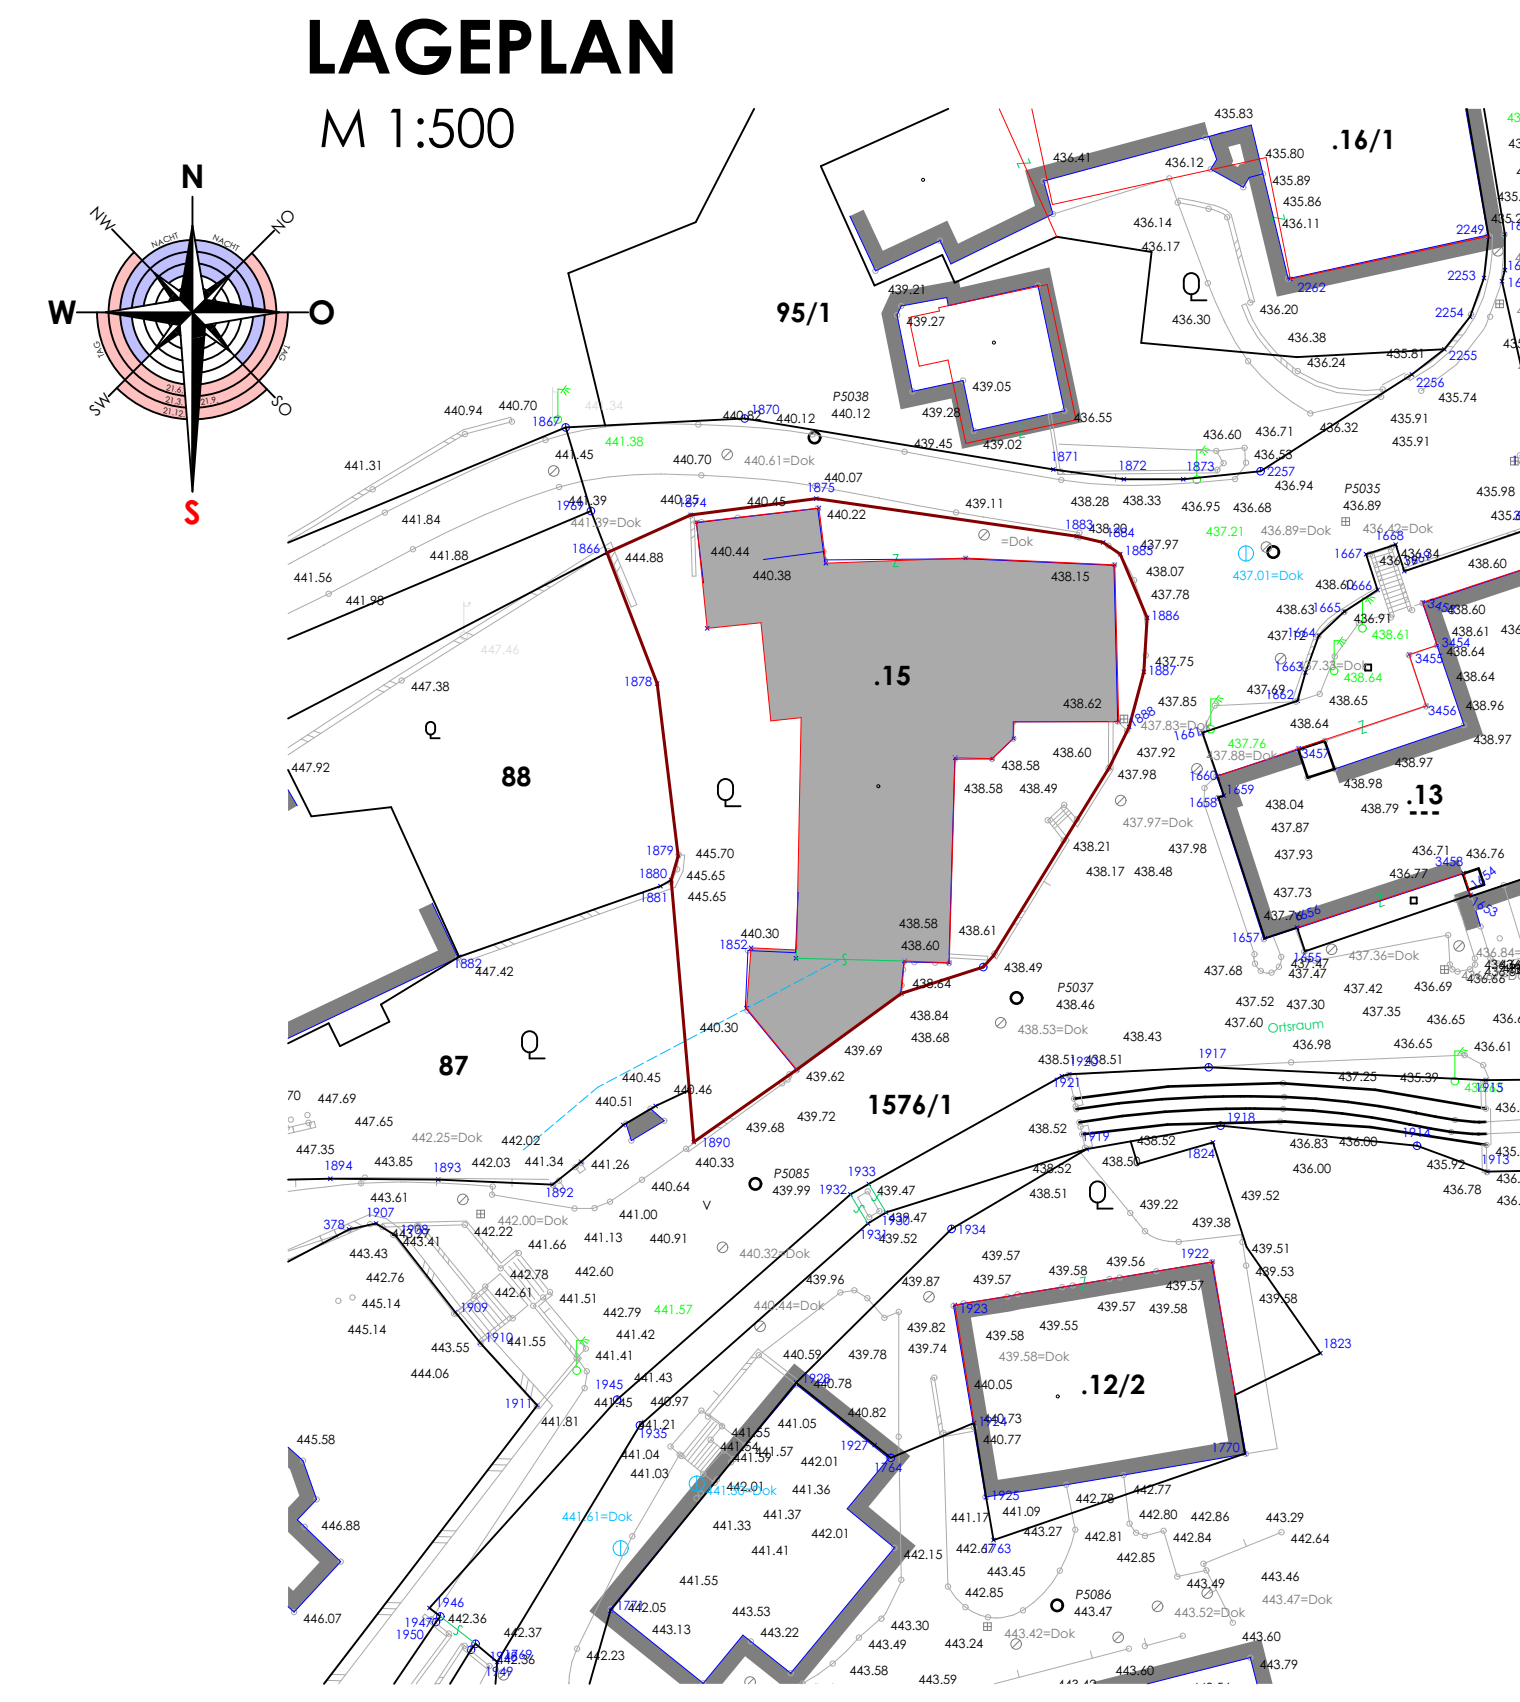
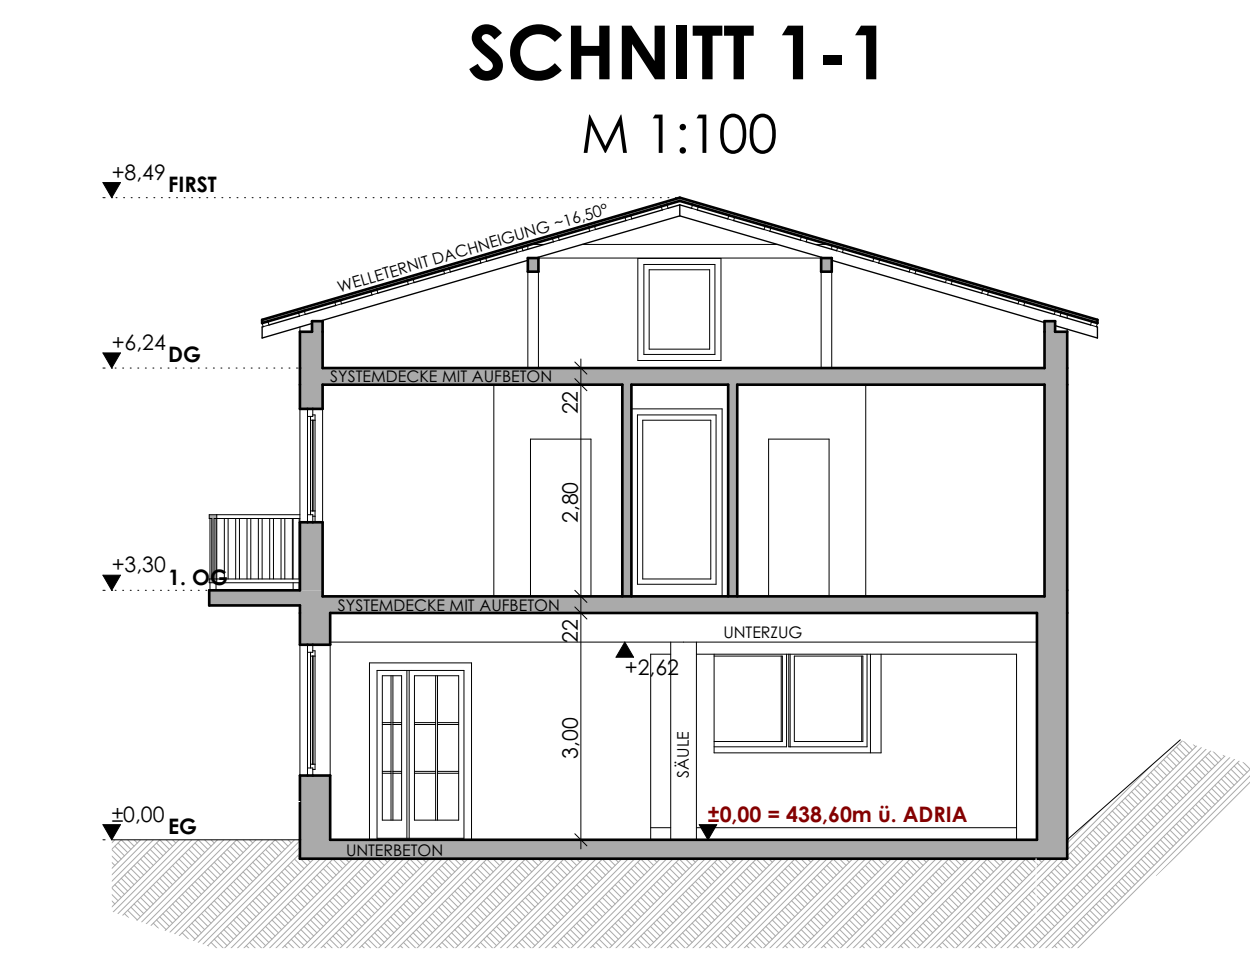


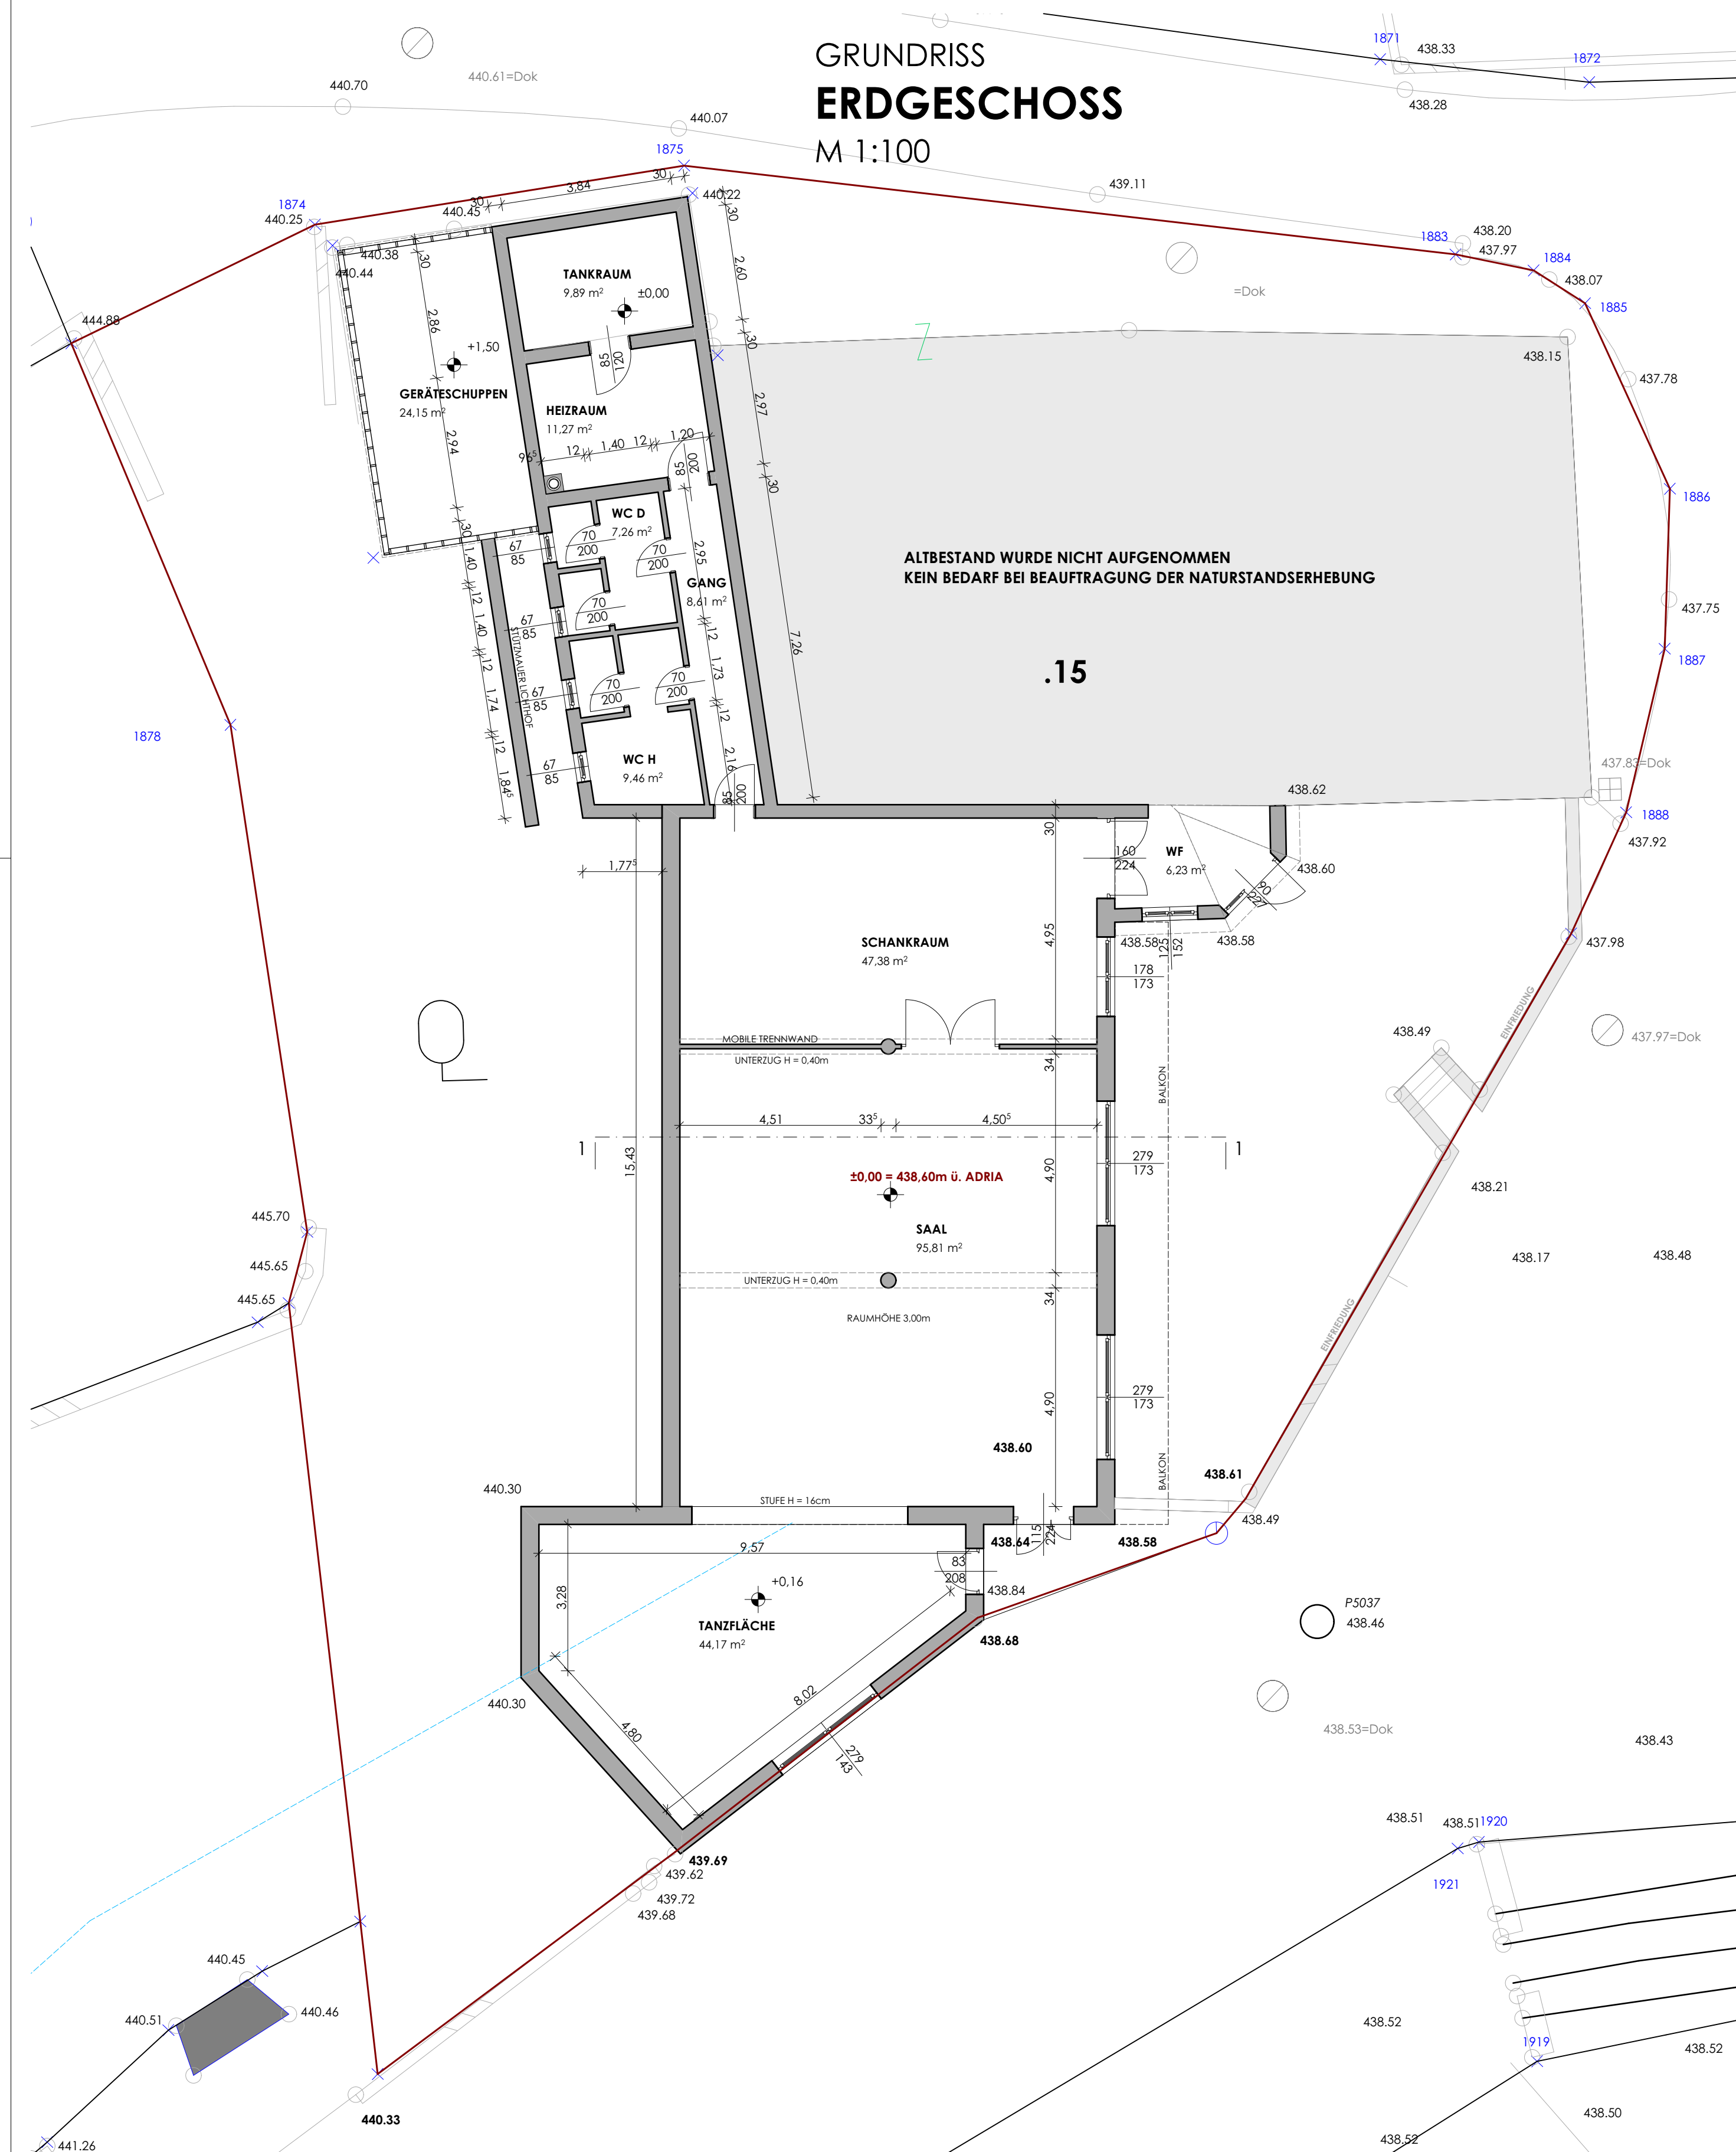

GEWERBETRIEB BSH				A		B		C		D		E	
BESTANDSPLAN													
GASTHAUS HÖZL													
Projekt:													
Gst. Nr.:		.15		Ez:		54		Kt.:		19208 LOICH			
Planinhalt:				GRUNDRISS SCHNITT LAGEPLAN				Maßstab: 1:100 1:500					
Bauwerber:				HERR JOHANNES HÖZL LOICH 8 3211 LOICH				Grundstückseigentümer: HERR JOHANNES HÖZL LOICH 8 3211 LOICH					
Bauführer:								Planverfasser: HB CONSTRUCTS PLANUNG & BAUMANAGEMENT					
L		■ TEGEL (NEU)		GEOSCHICHTSBEZEICHNUNGEN				P		P			
E		■ STAHLBETON		EG Erdgeschoss				P		P			
G		■ UNVERWEHRTER BETON		OG Obergeschoss				P		P			
E		■ DÄMMUNG HART		UG Untergeschoss				P		P			
N		■ DÄMMUNG WEICH		DG Dachgeschoss				P		P			
D		■ HOLZ		KG Kellergeschoss				P		P			
E		■ BESTAND		HÖHNHOLZ- UND MASSEHOLZ				P		P			
		■ ABRUCH		FHOZ fertige Fußbodenbänke				P		P			
				DOK Deckenbänke (Rohbaumal)				P		P			
				DOK Deckenbänke (Rohbaumal)				P		P			
				STUR Sturzwandbänke (Rohbaumal)				P		P			
				RPH Rohbauwandbänke				P		P			
				FPH fertige Parapetbänke				P		P			
				gemessen von FHO bis				P		P			
				Oberkante des inneren Fensterbretts				P		P			
Vermerk der Behörde:								HB CONSTRUCTS PLANUNG & BAUMANAGEMENT					
								HB CONSTRUCTS PLANUNG & BAUMANAGEMENT					
								HB CONSTRUCTS PLANUNG & BAUMANAGEMENT					
								HB CON					